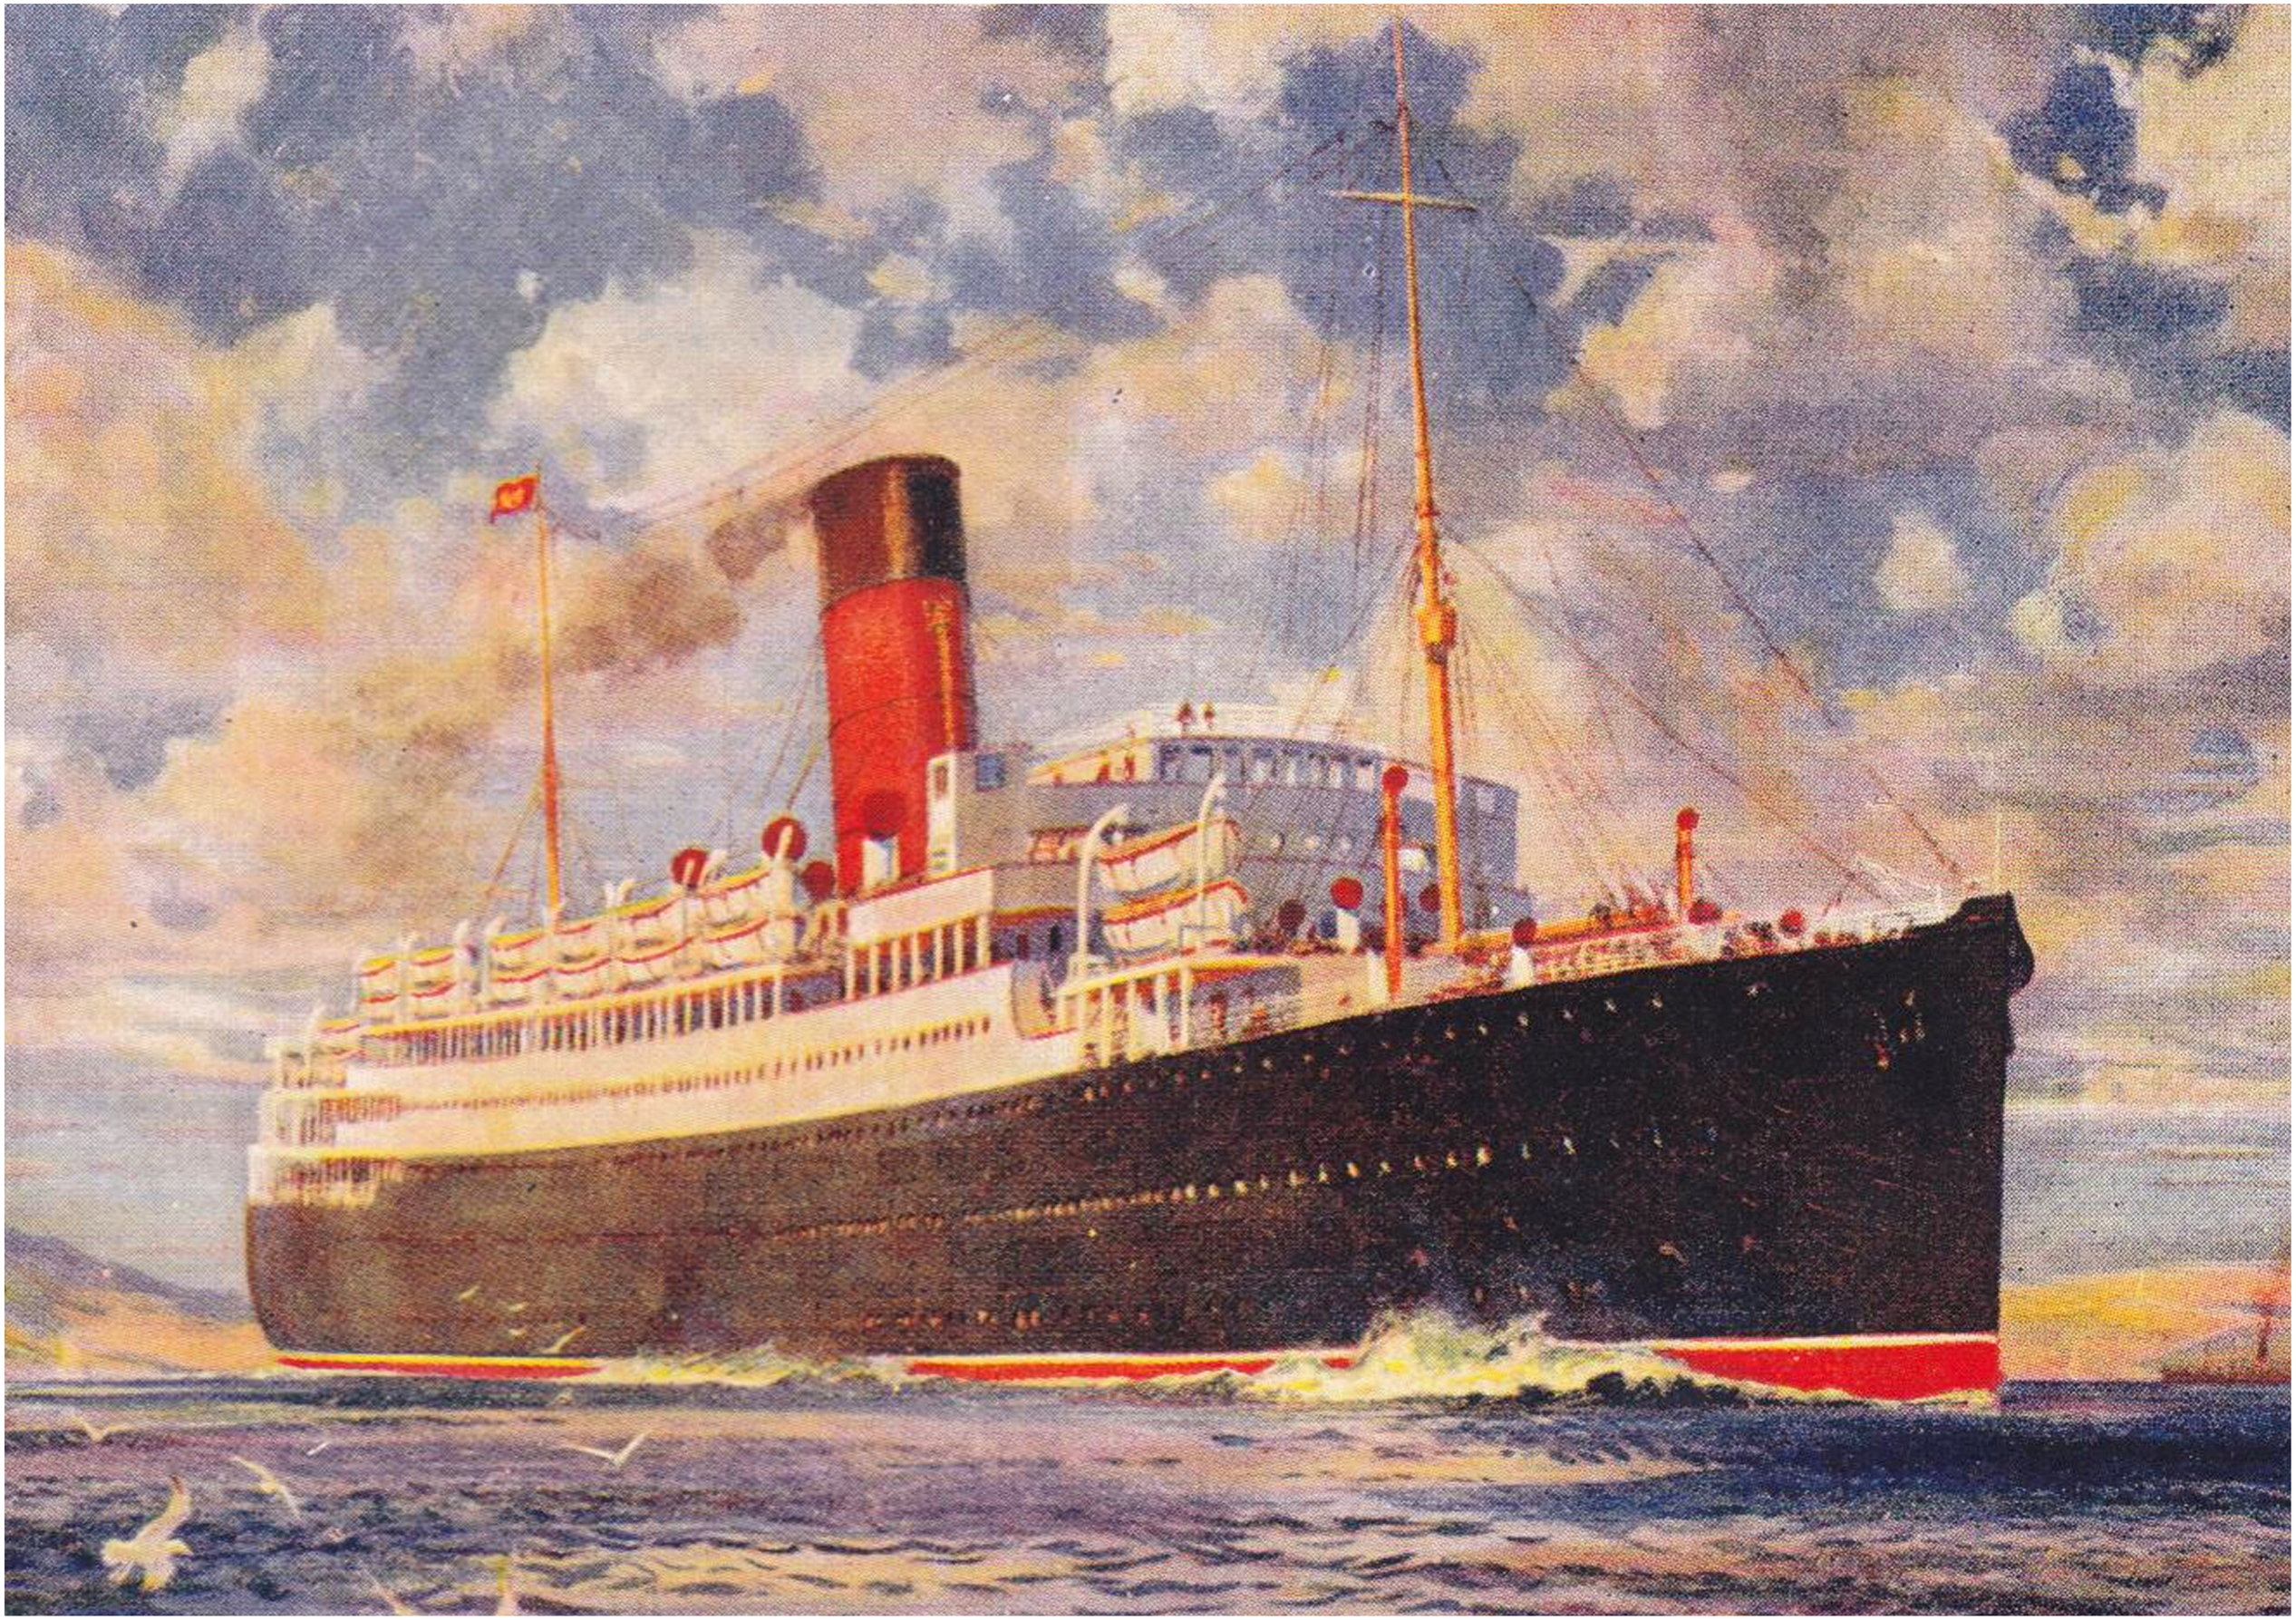

T.S.S. "TYRRHENIA"

Wm BEARDMORE & Co Nº 557.

PROFILE AS BUILT.

Glasgow Report Nº 42003.

Lancastria

Mr 1 D 7

Lancastria

RETAIN

© 2018
Lloyd's Register Foundation

T. S. S. "TYRRHENIA".

STRUCTURAL PROFILE.

SCALE $\frac{1}{8}$" = 1 FOOT.

MOULDED DIMENSIONS 550 B.P. x 70' x 42'-9 TO 'C' DECK.

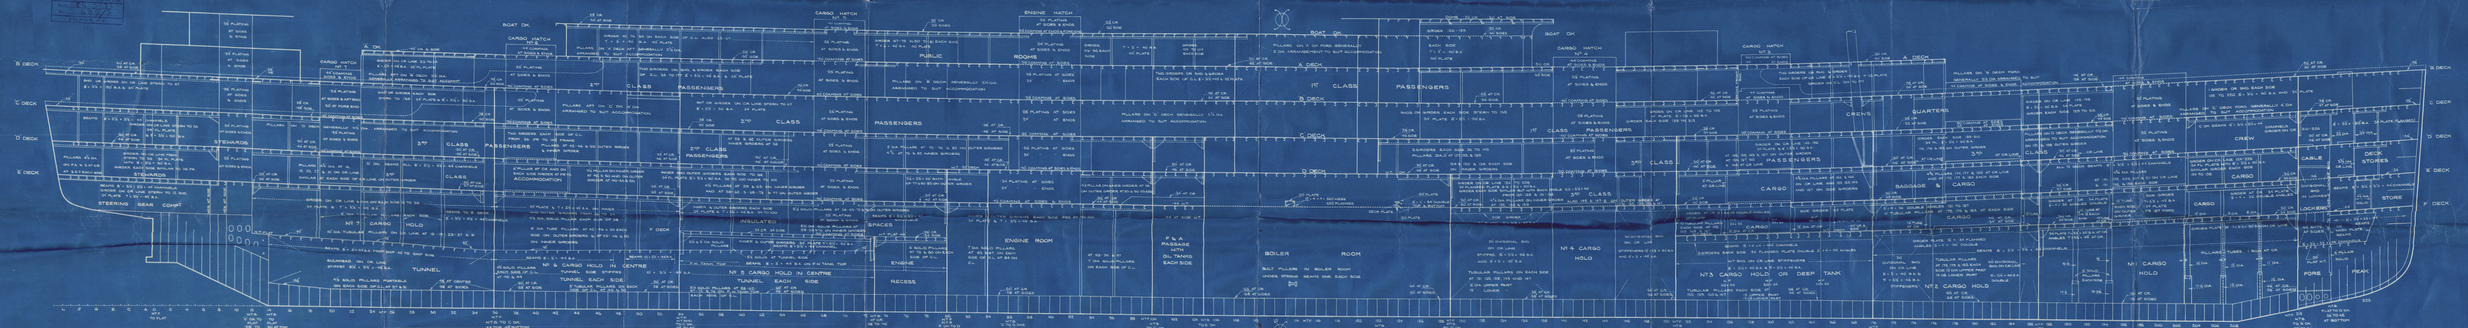

A Deck

RETAIN

n/n "Lancastria"

ex

" Tyrrhenia

© 2018
Lloyd's Register
Foundation
LR/FAF-1825 P-5

—Nos 557 to 584.—

—A DECK PLATING.—

—Scale ½" = 1 Foot.—

BEAMS 8" × 3½" × 3½" × .44" CHANNELS ALL LOOK TOWARDS AMIDSHIPS EXCEPT WHERE OTHERWISE INDICATED.

—EXISTING TABLE SHOWS THUS—
—DOUBLE RIVETED—

THICKNESS OF PLATING	RIVETING	WIDTH OF BUTTS	WIDTH OF PLATING BETWEEN RIVETS	WIDTH OF HOOD BUTTS
above 3/4"	7/8"	12" ctrs	10 1/2 ins	9 ins
3/4" — 11/16"	7/8"	11 ins	9 1/2 ins	8 ins
11/16" — 5/8"	7/8"	10 1/2 ins	9 1/2 ins	8 ins

		WIDTH OF HOOD
3/4" — 5/8"	7/8"	9 ins	8" ctrs
5/8" — 9/16"	7/8"	8 ins	7" ctrs
9/16" — 1/2"	7/8"	7 ins	6" ctrs
1/2" — 7/16"	7/8"	6 ins	5 ins

—Elevation showing Break in Shell—

—Elevation showing Break in Shell—

557-584

Beardmore

B DECH

RETAIN

n/n Lancastria

etc

"Tyrrhenia"

© 2018
Lloyd's Register Foundation

No 557 & 584

B DECK PLATING

SCALE ⅛" = 1 FOOT.

BEAMS 6 - 3½ - 8½ - 4½ CHANNELS ALL LOOK TOWARDS AMIDSHIPS EXCEPT WHERE OTHERWISE INDICATED.

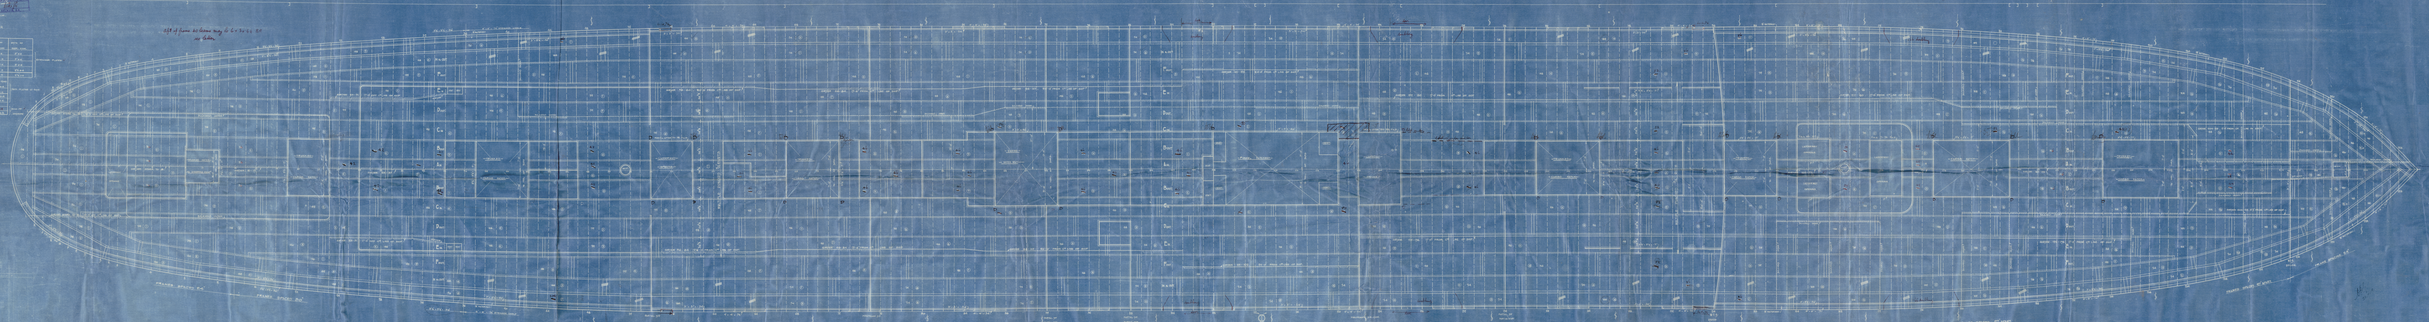

C. Deck Plating

Spec 584 - 5-54

Recession No 25

m/n "Lancastria"

ex

"Tyrrhenia"

RETAIN

© 2018
Lloyd's Register
Foundation

B25-P-4

Nº 557 & 584

C. DECK PLATING.

SCALE ½ INCH = ONE FOOT.

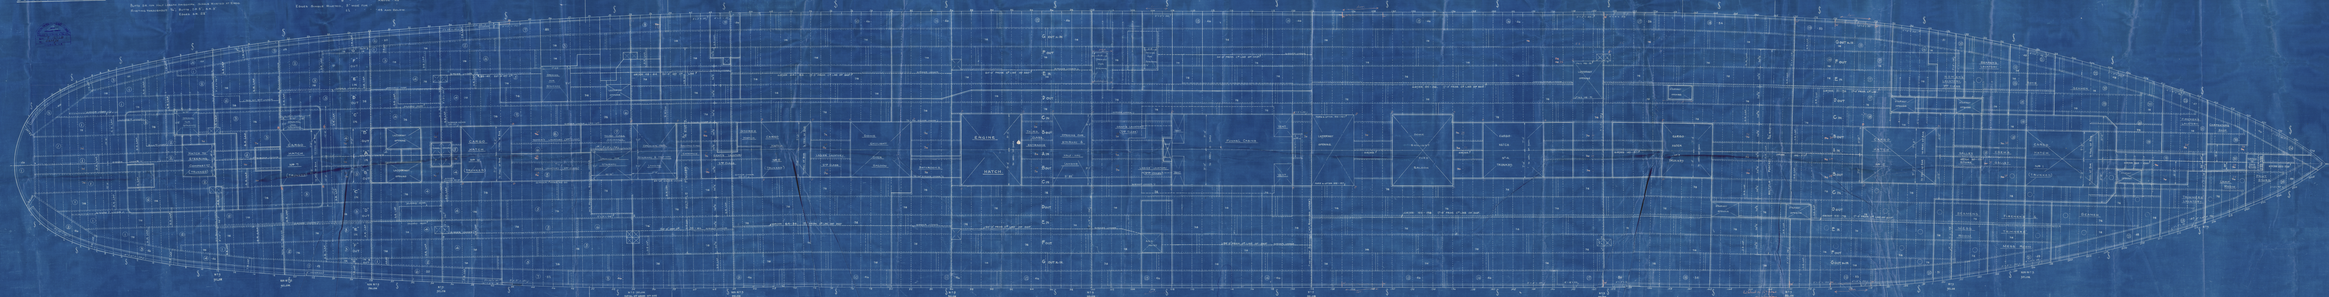

BUILDERS. Wm. Beardmore & Coy. Ltd.

YARD No. 557

PLAN. D Deck Plating

PLAN

LLOYDS REGISTER OF SHIPPING
RECEIVED
17 MAR 1915
LONDON.

SHIP'S NAME n/s "Lancastria"

GLASGOW REPORT No

ex

"Lyrberia"

© 2018
Lloyd's Register
Foundation

N°557 to 584.

'D' DECK PLATING

SCALE 1/4" = 1'-0"

D DECK

BEAMS 6" 5½" 5" 4½" CHANNELS LOOKING TOWARDS AMIDSHIPS EXCEPT WHERE OTHERWISE INDICATED

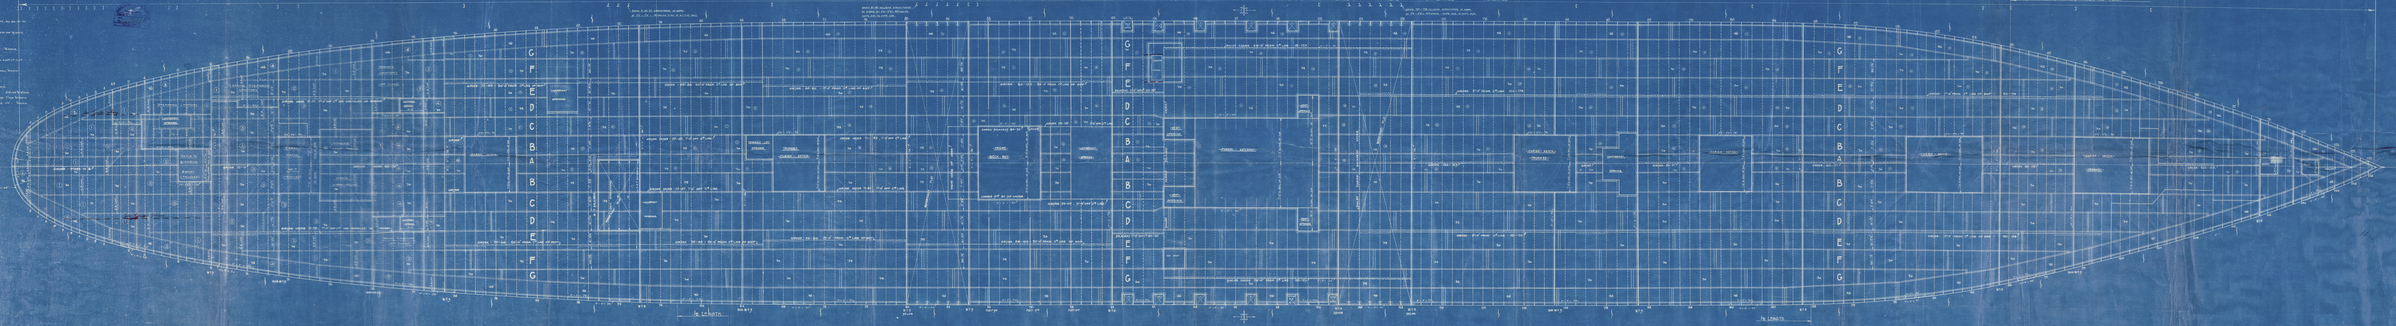

557

E deck

Beardmore & Co.

LLOYDS REGISTER OF SHIPPING
RECEIVED
4 - FEB 1919
LONDON.

E' deck

RETAIN

Office copy

n/s "Lancastria"

&

"Tyrrhenia"

© 2018
Lloyd's Register
Foundation

Nº 557.

E DECK PLATING.

SCALE ½" = 1 FOOT.

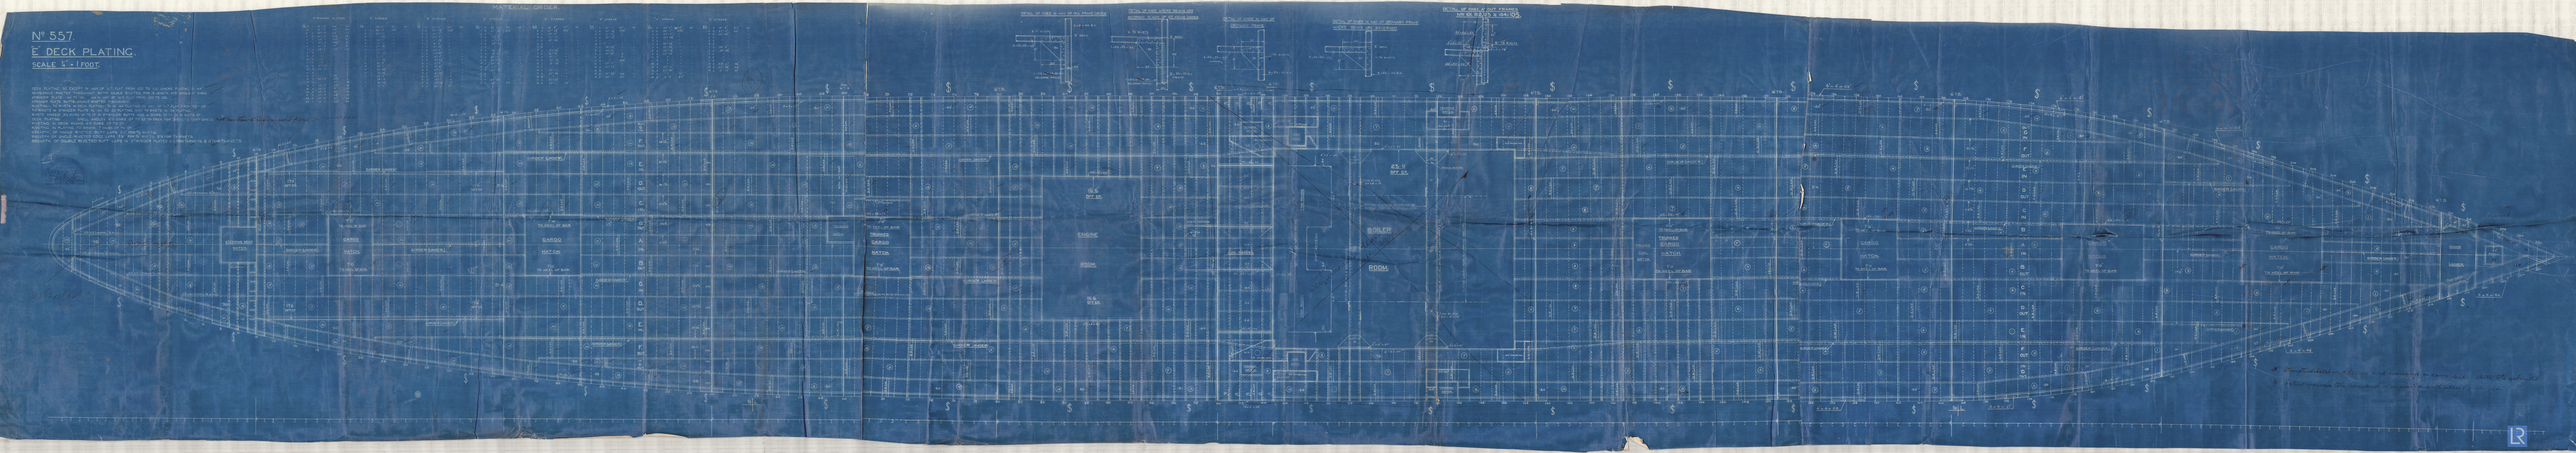

T.S.S. "Tyrrhenia"

Wm Beardmore & Co No 557.

Midship Section as Built.

Glasgow Report h° 42003.

"Lancastria"

RETAIN

© 2018
Lloyd's Register
Foundation

Lanaastria

© 2018
Lloyd's Register
Foundation

T. S. S. "TYRRHENIA".

MIDSHIP SECTION

OF

PASSENGER & CARGO STEAMER.

SCALE $\frac{1}{2}$" = 1 FOOT.

LENGTH = L = 550'-0"
BREADTH = B = 70'-0"
DEPTH = D = 42'-9" TO BULKHEAD OR 'C' DECK.
DRAUGHT = d = 28·7 FEET.

MOULDED DIMENSIONS

550'-0" B.P. x 70'-0" x 42'-9" TO "C" Dk

LENGTH ON L.W.L. = 572'-6" CRUISER STERN.

NAVAL CONSTRUCTION WORKS
DRAWING OFFICE
WILLIAM BEARDMORE & Co. LTD.
DATE 24 5 17
No. 6345
DALMUIR, N.B.

LLOYD'S NUMERALS & PROPORTIONS

1ST NUMBER 70 + (42·75 - 8) = 104·75

2ND " 551·1 x 104·75 = 57728

$\frac{L}{D} = \frac{551·1}{42·75} = 12·9$

PLANKING.

HOUSE TOPS	5" x 2½"	PITCH PINE MARGINS	6" x 3½" TEAK
UPPER BRIDGE	5" x 2½"	" " "	6" x 3½" "
BRIDGE DECK	5" x 2½"	" " "	6" x 3½" "
DOCKING BRIDGE	5" x 2½"	" " "	6" x 3½" "

LLOYD'S EQUIPMENT NUMERAL

2ND NUMERAL 553 x 104·75 = 57926 — 57926

'D' TO 'C' DECK:-

ENCLOSED $\frac{553 \times 8 \times 3}{4}$ = 3318 — 3318

'C' TO 'B' DECK:-

ENCLOSED $\frac{457 \times 8·5 \times 3}{4}$ = 2915

DECKHOUSE CASING $\frac{20 + 48½ \times 8·5 \times 1}{2}$ = 291 — 3206

'B' TO 'A' DECK:-

ENCLOSED $\frac{(5 + 18 + 257½) \times 8 \times 3}{4}$ = 1683

DECKHOUSE $\frac{52 \times 8 \times 1}{2}$ = 208 — 1891

ABOVE 'A' DECK:-

DECKHOUSE $\frac{60 \times 8 \times 1}{2}$ = 240

$\frac{155 \times 8 \times 1}{2}$ = 620

$\frac{22½ \times 8 \times 1}{2}$ = 90 — 950

EQUIPMENT Nº = 67·291

ANCHORS AND CABLES

	CWT	QR	LBS	
1ST BOWER	137	2	25	
2ND "	137	2	0	
3RD "	115	0	2	
COLLECTIVE	390	0	27	ALL STOCKLESS

165 FATHOMS 2 15/16 DIA. STUD-LINK CABLE } TOTAL W.T.
165 " 2 15/16 " " " " } 1440 CWTS

TOW LINE 140 FMS. 7½ CIRC.
HAWSERS & WARPS 5 AT 120 FMS 8 CIRC.
" 4 AT 120 FMS. 3¾ "
" 120 FMS. 4 "
CABLE 150 FMS. 6½ "

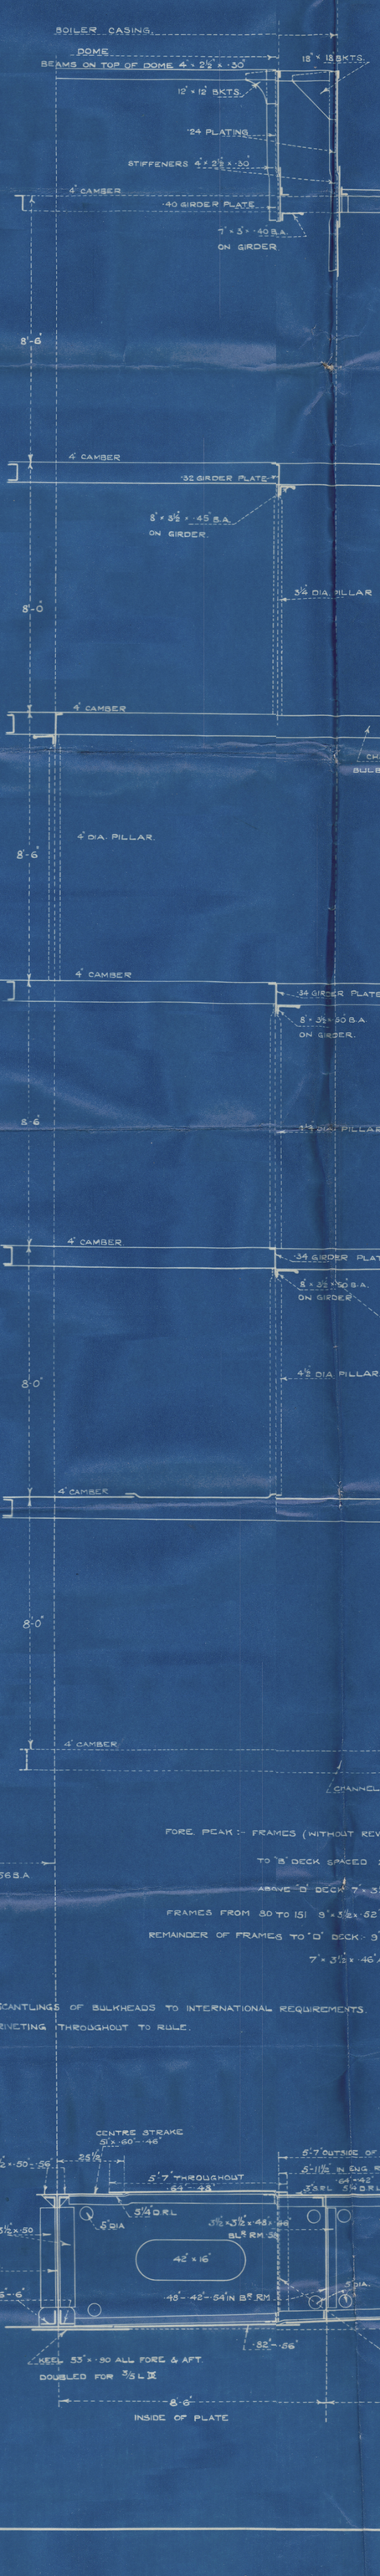

© 2018 Lloyd's Register Foundation

Wm Beardmore & Co Ltd.

D. E. Boilers Nos 5-5-7

Duplicates of 584.

"Tyrrhenia"

Qls. 4200 B.

"

"Lancastria"

© 2018
Lloyd's Register
Foundation

LIST OF PLATES FOR 3 D.E. BOILERS

LETTER	No. REQ'D	LENGTH	BREADTH	THICK	PURPOSE	TENSILE TONS PER SQ. INCH
18B	12	12'-0"	4'-10¼"	15/16	CENTRE FIREBOX TUBE PLATE	26-30
15B	12	12'-0"	4'-10¼"	23/32	" " BACK	26-30
16B	12	8'-10⅛"	5'-9⅞"	15/16	WING " TUBE PLATE	26-30
17B	12	8'-10⅛"	5'-9⅞"	23/32	" " BACK	26-30
20B	12	3'-2⅝" 3'-7" 3'-9" 3'-2⅝"	4'-7⅛" 4'-10" 4'-10" 4'-7⅛"	25/32	CENTRE FIREBOX WRAPPER	26-30
21B	12	3'-2⅝" 3'-5" 3'-5" 3'-2⅝"	1'-3" 1'-3" 0'-6" 0'-6"	13/32	WING FIREBOX WRAPPER	26-30
9B	6			1¼	END PLATE TOP	26-30
10B	6			1"	END PLATE BOTTOM	26-30
11B	12	6'-10½"	1'-0"	1"	END PLATE (DOUBLING)	26-30
12B	42	6'-9"	2'-10"	⅝	FIRE BOX KNOCKERS)	26-30
13B	3	4'-4"	3'-9⅞"	½	" SUPPORTS	28-32
1B	6	31'-3"	7'-11⅛"	15/32	SHELL OUTER TOP	30-34
2B	6	24'-5½"	7'-11⅛"	19/32	" BOTTOM	30-34
3B	3	18'-9⅞"	7'-11⅛"	19/32	" INNER TOP	30-34
4B	3	35'-10⅜"	7'-11⅛"	19/32	" BOTTOM	30-34
5B	12	7'-11⅛"	2'-0⅝"	19/32	BUTT STRAP OUTER OUTER STRIP	30-34
6B	12	6'-2"	2'-0⅝"	19/32	" " INNER "	30-34
7B	6	5'-0⅜"	2'-0⅝"	19/32	" OUTER INNER "	30-34
8B	6	7'-11⅛"	2'-0⅝"	19/32	" " INNER "	30-34
19B	6	8'-0"	2'-5"	23/32	CENTRE FIREBOX WRAPPER (2 IN.)	26-30
19B	12	7'-11⅛"	2'-6"	23/32	WING " "	26-30

FOR ORDER FOR PLATES FOR 584 lbs BOILERS SEE SK. Nos 225 & 226

- " " FURNACES " " " " No 282
- " " TUBES " 584 & 557 lbs " " " No 283
- " " MANHOLE DOORS " " " " " No 284
- " " STEEL STAY BAR MATERIAL FOR 584 & 557 lbs BOILERS SEE SK. No 285
- " " IRON " " " " " No 286
- " " PLATES FOR 557 lbs BOILERS SEE SK. Nos 287 & 288
- " " FURNACES " " " " No. 289

	I.D.E.	I.G.E.	TOTAL	RATIO
GRATE AREA	165.0 ft²	82.344	746.464	44.3
HEATING & SUPERHEATING TUBES	6329.0 ft²	2604.54	23910.64	32.2
" FURNACE	923.16	211.57	1904.196	
" RADIAL	758.71	348.83	3272.88	
TOTAL HEATING SURFACE	8011.0 ft²	3164.94	29087.72	33.05
AREA THRO' TUBES	47.926 (13.363)ft²		125.667	5¼ & 9/32
WITH SUPERHEATER				
STEAM CAPACITY	1121.8 ft³	574.6 ft³	5097.6 ft³	6.82

LIST OF SCREWED IRON TUBES (3 D.E. BOILERS)

LETTER	QTY.	KIND	SIZE	FINISHED ENDS
	1860	PLAIN	2"	ENDS 8/16"
A	132	STAY	"	8/16" WITH NUTS
A	276	"	¾	8/16" WITHOUT NUTS
B	264	"	"	8/16" " "
C	288	"	⅝	8/16" "

6 STEEL ANGLE BARS 4"x3½"x24⅝" LONG FIREBOX SUPPORTS
TENSILE STRENGTH 26 TO 30 TONS ELONGATION 25% IN 8 INCHES

Tensile Strength of Compensating Rings 26-30 tons.

This radius & hole in shell to be made as small as possible.

Hole in shell 16½ (Manhole)

Detail of stays between combustion chamber & shell

Screwed 9 threads per inch

Bulged

Plate = 29/32" thick
Rivet = 15/16" thick

Rivets 1⅛ dia finished (machine)
Long joint plate = 84·238%
Rivet = 59·03% "
Rivet = 58·6% Lloyd's

Rivets 1⅛ dia Finished (machine)

Shell plates 1⅛ thick Butt straps 1" thick outside 15/16" inside

To Board of Trade & Lloyds Requirements & Tests.

Working Pressure = 220 lbs per sq inch.
Test " = 385 " "

Steel throughout excepting tubes & combustion chamber stays which are of iron.

All holes drilled in place after bending.

Tensile strength of shell plates & butt straps 30 to 34 tons per sq inch with elongation of 20% in 8 inches.
Tensile strength of girder plates 26 to 30 tons per sq inch with elongation of 20% in 8 inches.
Tensile strength of end plates & combustion chamber plates 26 to 30 tons per sq inch with elongation of 25% in 8 inches.
Combustion chamber stayed plates to be iron having tensile of 22 tons per sq inch with elongation of 27½ in 8 inches.
Plates supplied by:

6 Stay tubes ¾ thick 1'-4½" above to be supplied spare

Screwed 9 threads per inch

52 plain tubes to be supplied spare

Tubes lapwelded iron

Middle Cir.ar seam machine

Butt strap end cir.ar seams & manhole comp. plate

End cross seams & doublings hand & machine

Fireboxes & furnaces hand & machine

Fireboxes & furnaces

Buttstrap on mid strake

Buttstrap on end strakes

For long. position of manhole see 1 and 2 of Boiler mountings

Fitted over

Edge not to be more than ⅛ wide for shipping.

C.P.H. Rivets 1⅛ pitch (Centres) Farm. Riveted Brickwork

Seal water level when boiler is in use

Fusible plug

Manhole

Mean Cir.ar = 664·939
158 pitches @ 3·327

Mean Cir.ar = 664·939
154 pitches @ 3·366

Machine riveted

Mean Cir.ar = 659·53
124 pitches @ 3·886

Hand Riveted

2-4 studs 5 centres

4½ x 3½ x ⅝ angles

⅝ bolts

3 stays to be annealed all over after being stayed up.

Mild steel stays 3 dia stayed up at ends in hydraulic press to 3½ dia & screwed 5 threads per inch

Nett area = 7·029 □"

3½ x ⅝ flat bar supports.

⅝ bolts

22'-6" mean length

Washers 3⅜ dia x ⅝ thick

Washers 6 dia x ½ thick

2 plates ⅞ thick

7'-10½" between tube plates

1⅛ dia rivets

Cast iron distance pieces

Cast iron distance pieces

Cast iron distance pieces

Cast iron distance pieces

340 tubes total

Grid plain tubes 2½ ext. dia x ·128 wig. thick

92 stay tubes 2½ ext. dia x ·128 wig. thick marked A

44 " " " " " " " A

88 " " " " " " " B

96 " " " " " " " C

Stays marked to 2⅜ dia screwed thro' both plates 3⅛ per inch & nutted

Edge stays 2½ dia. screwed thro' both plates 3⅛ per inch & nutted

Bracing ends 2½ dia screwed 8 threads per inch & nutted

Nett area = 2·330

Nett area = 2·330

Nett area = 2·330

Wm Beardmore & Co

No 557

Thrust Shaft as now made.

T.S.S. "Cyrhenia"

GLASGOW REPORT No.

M.V. "Lancastria"

RETAIN

© 2018 Lloyd's Register Foundation

LR-FHF-TB25-1-7

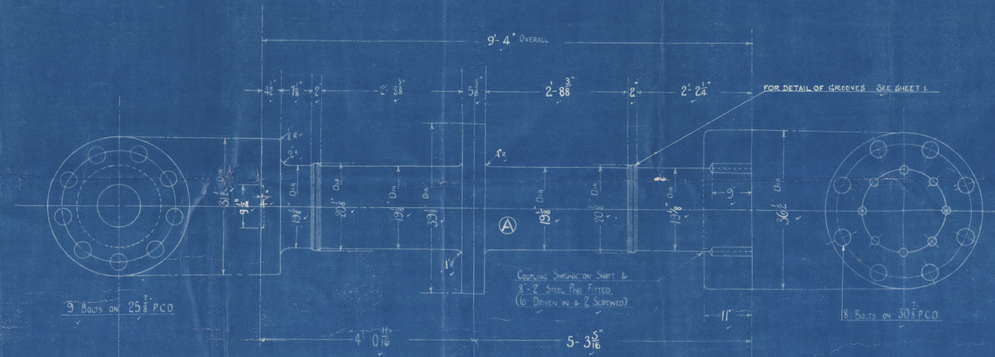

Thrust Shaft 2-Off.

Scale 1" = 1 Foot

Quantities Marked Are For Eng No 557 Only.

Mark	Description.	No Off. Working Comp.	No Off. Spare Comp.	Material.	Remarks.	Order No
A	Thrust Shaft.	2.		Ingot Steel		14160
B	Coupling. Thrust Shaft.	2.		" "		193 T. 584-557
C	Pins for Coupling " "	16		Steel	⅛ Driven. 4. Screwed. Tensile Strength 28 to 32 Tons.	192 T. 584-557.
D	Coupling Bolts.	16	2.	Steel		192 T. 584-557

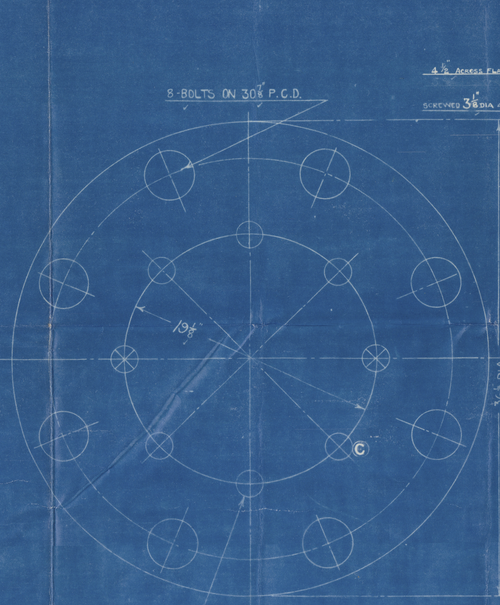

Detail of Coupling

Scale 3" = 1 Foot

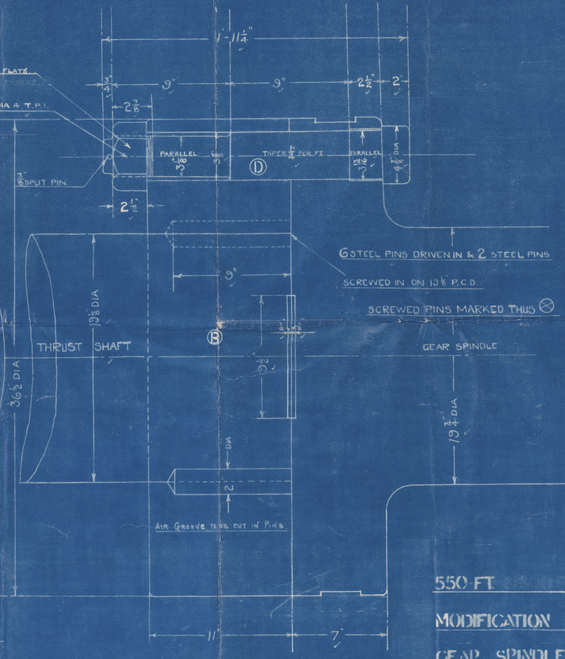

24.3.20.

Hazelines 24.3.20.

24.3.20

Mr Bouchelow 24.3.20.

Cost Section. Working 8. Spare 20.

From William Beardmore & Co., Limited, (Engine Departments), Dalmuir.
Enclosure
Lloyd's Register of Shipping Glasgow
573

550 FT CUNARDERS.

MODIFICATION TO THRUST SHAFT. & GEAR SPINDLE COUPLINGS.

SCALES:- 1" & 3" = 1 FOOT

Eng. No. 557

— 2 Sheets — Sheet 2.

Lords

14160

E. 1236 584

Hazelines 1.12.20